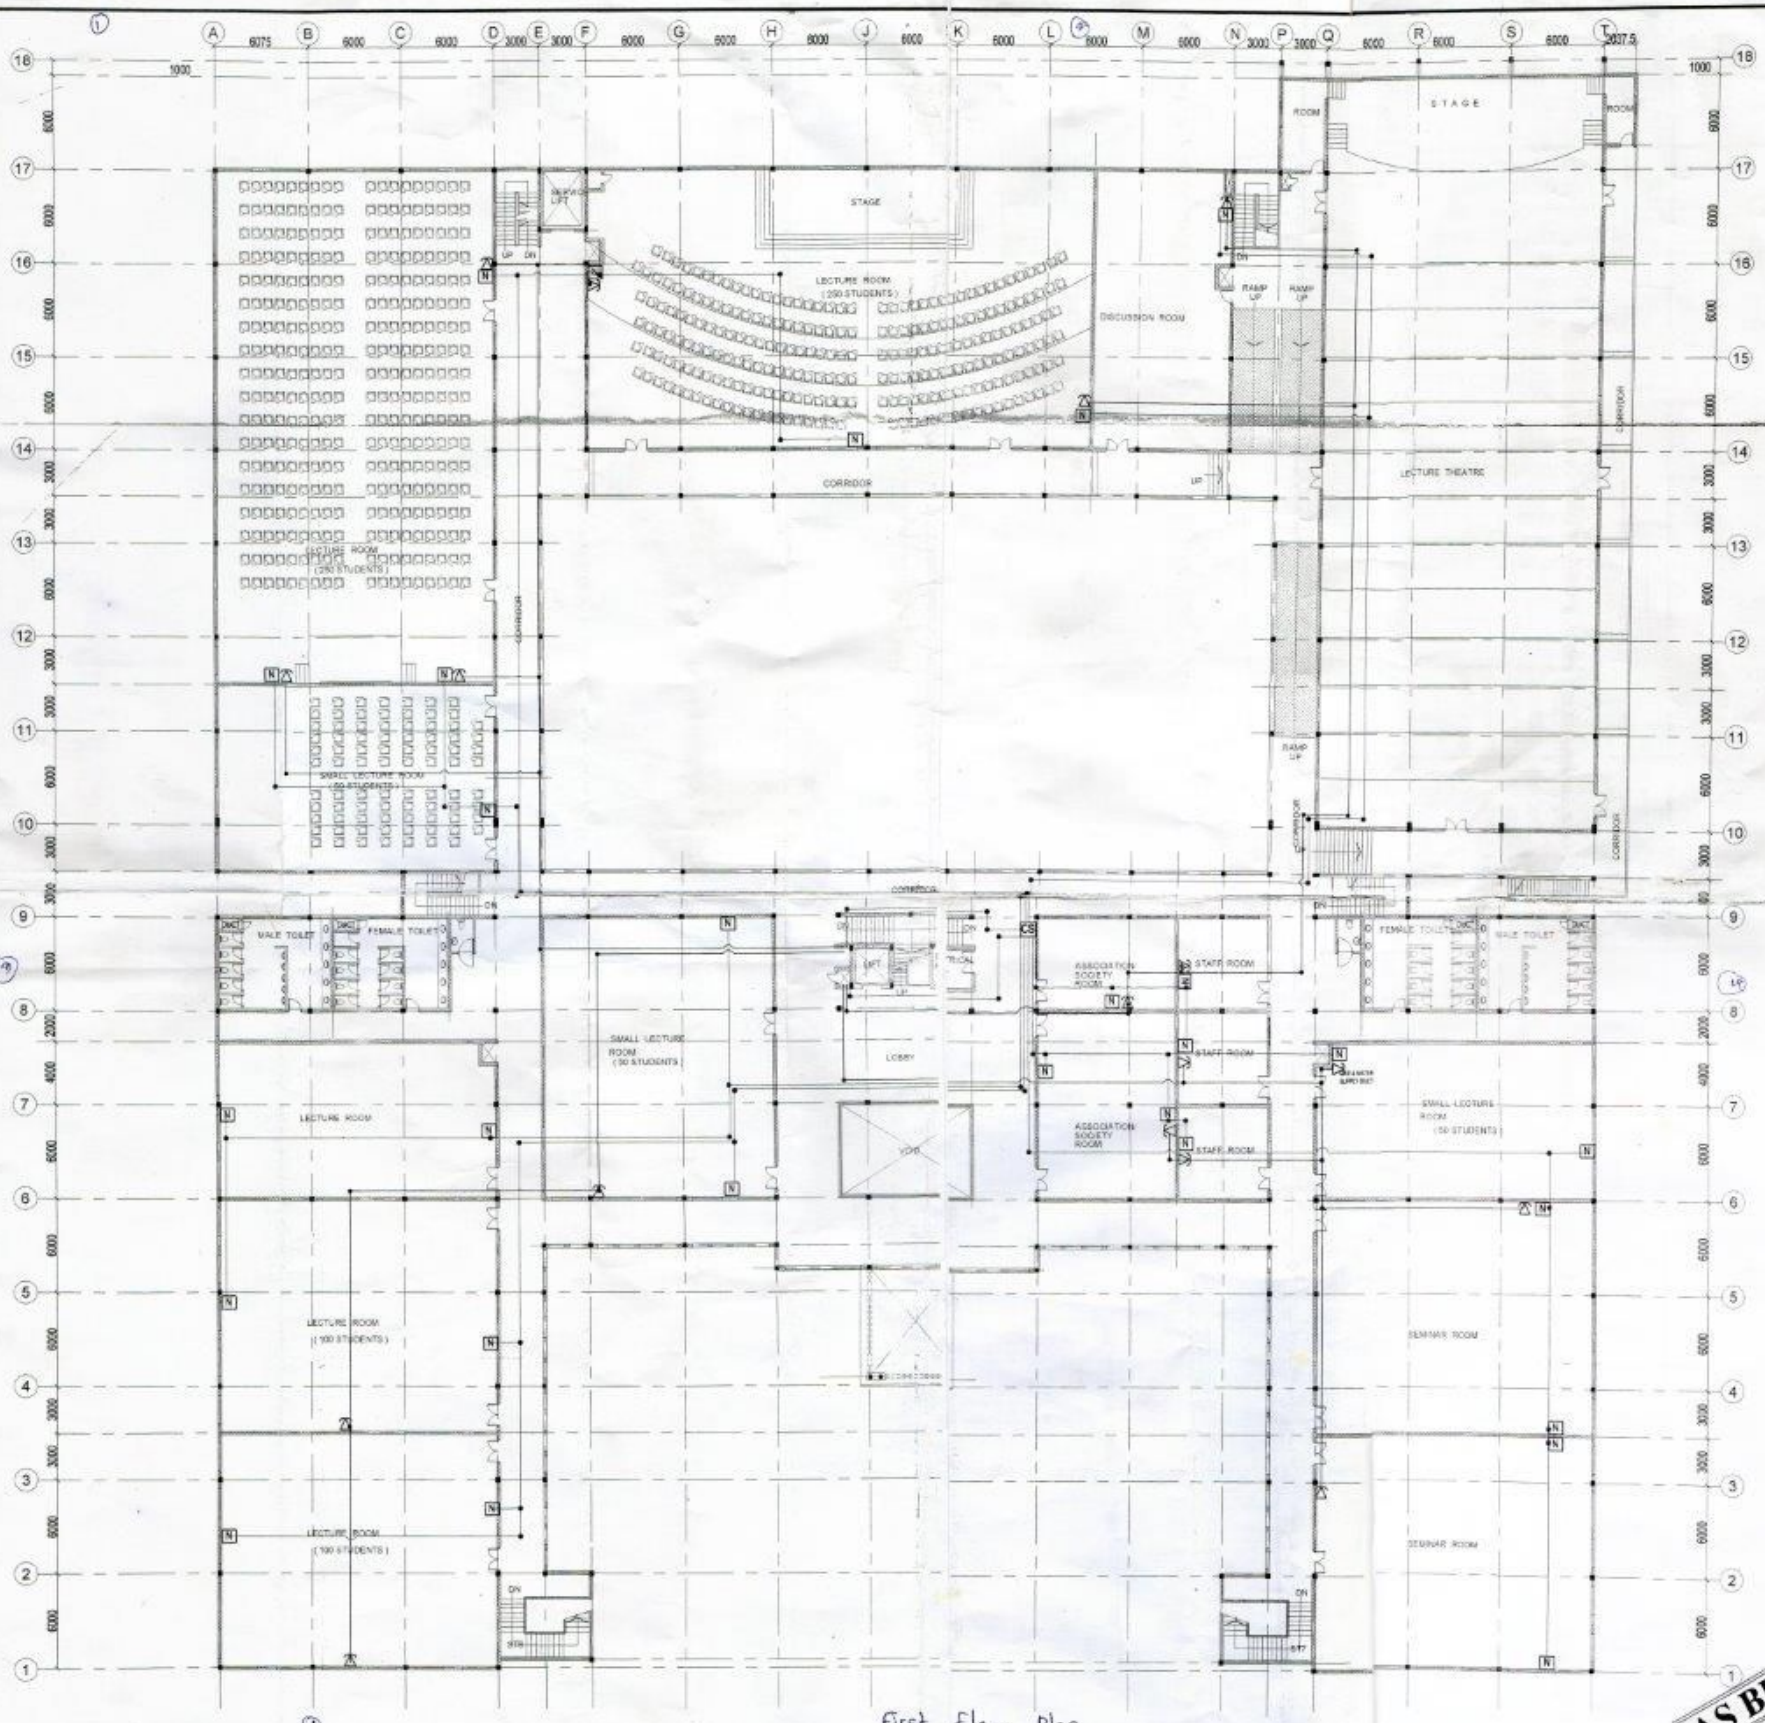

First floor Plan

AS BUILT

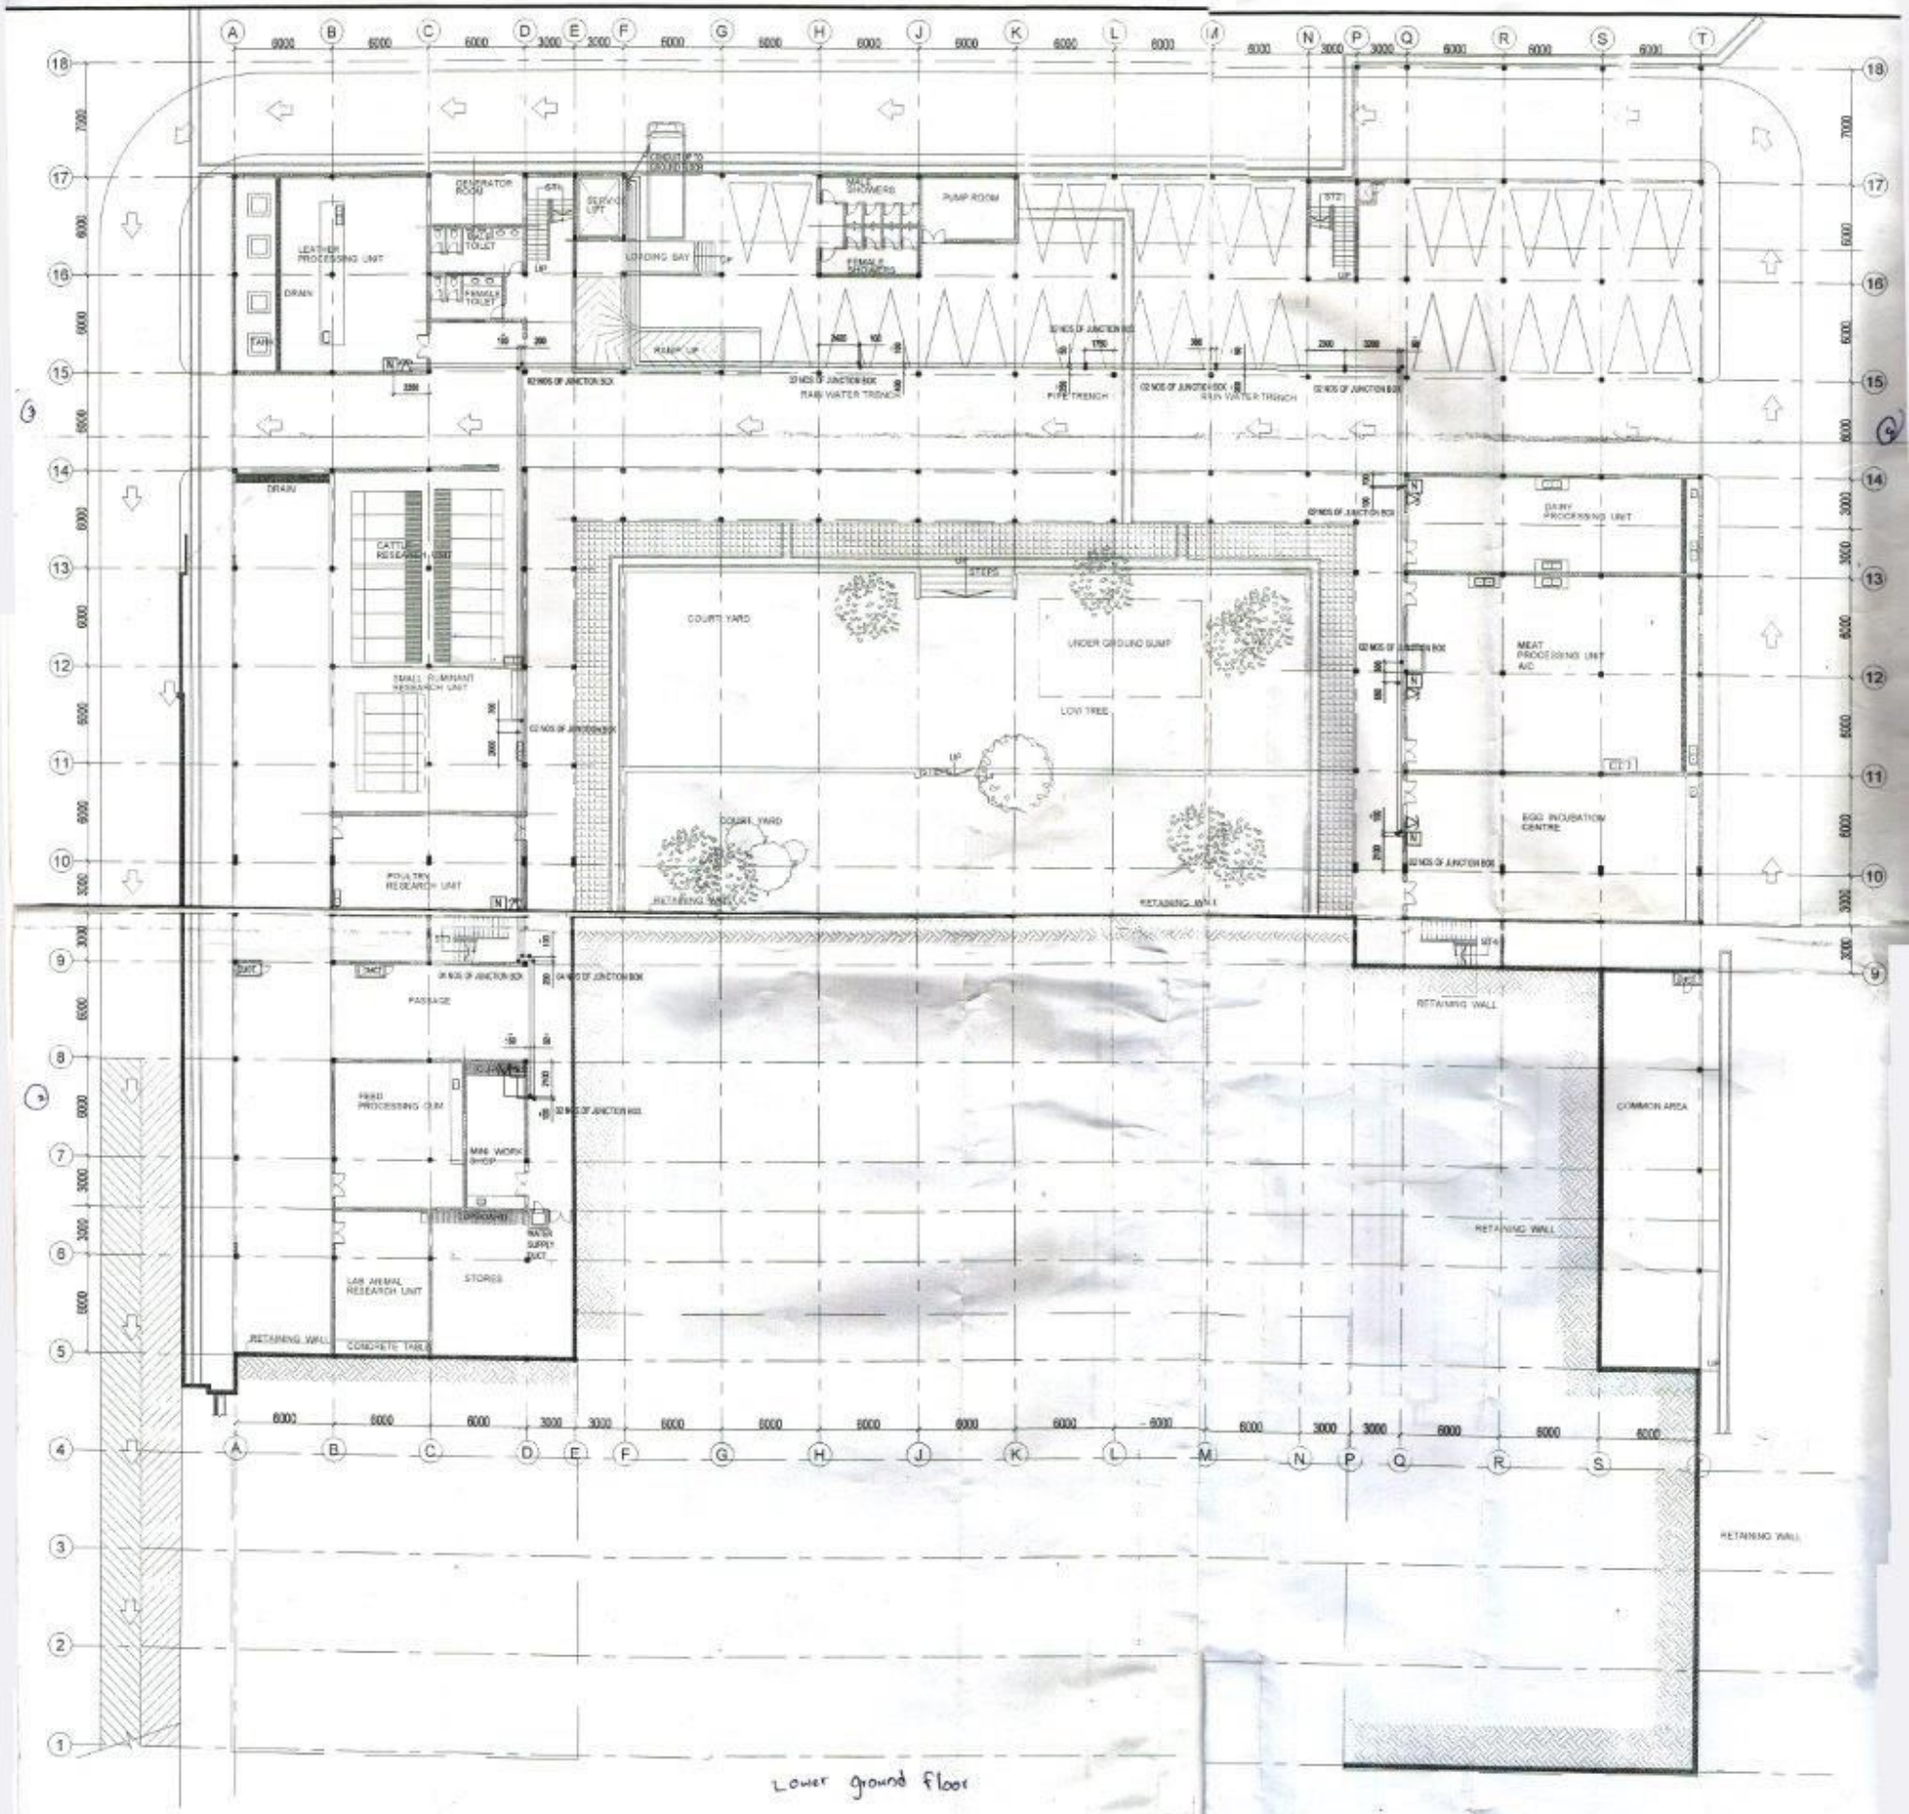

Lower ground floor

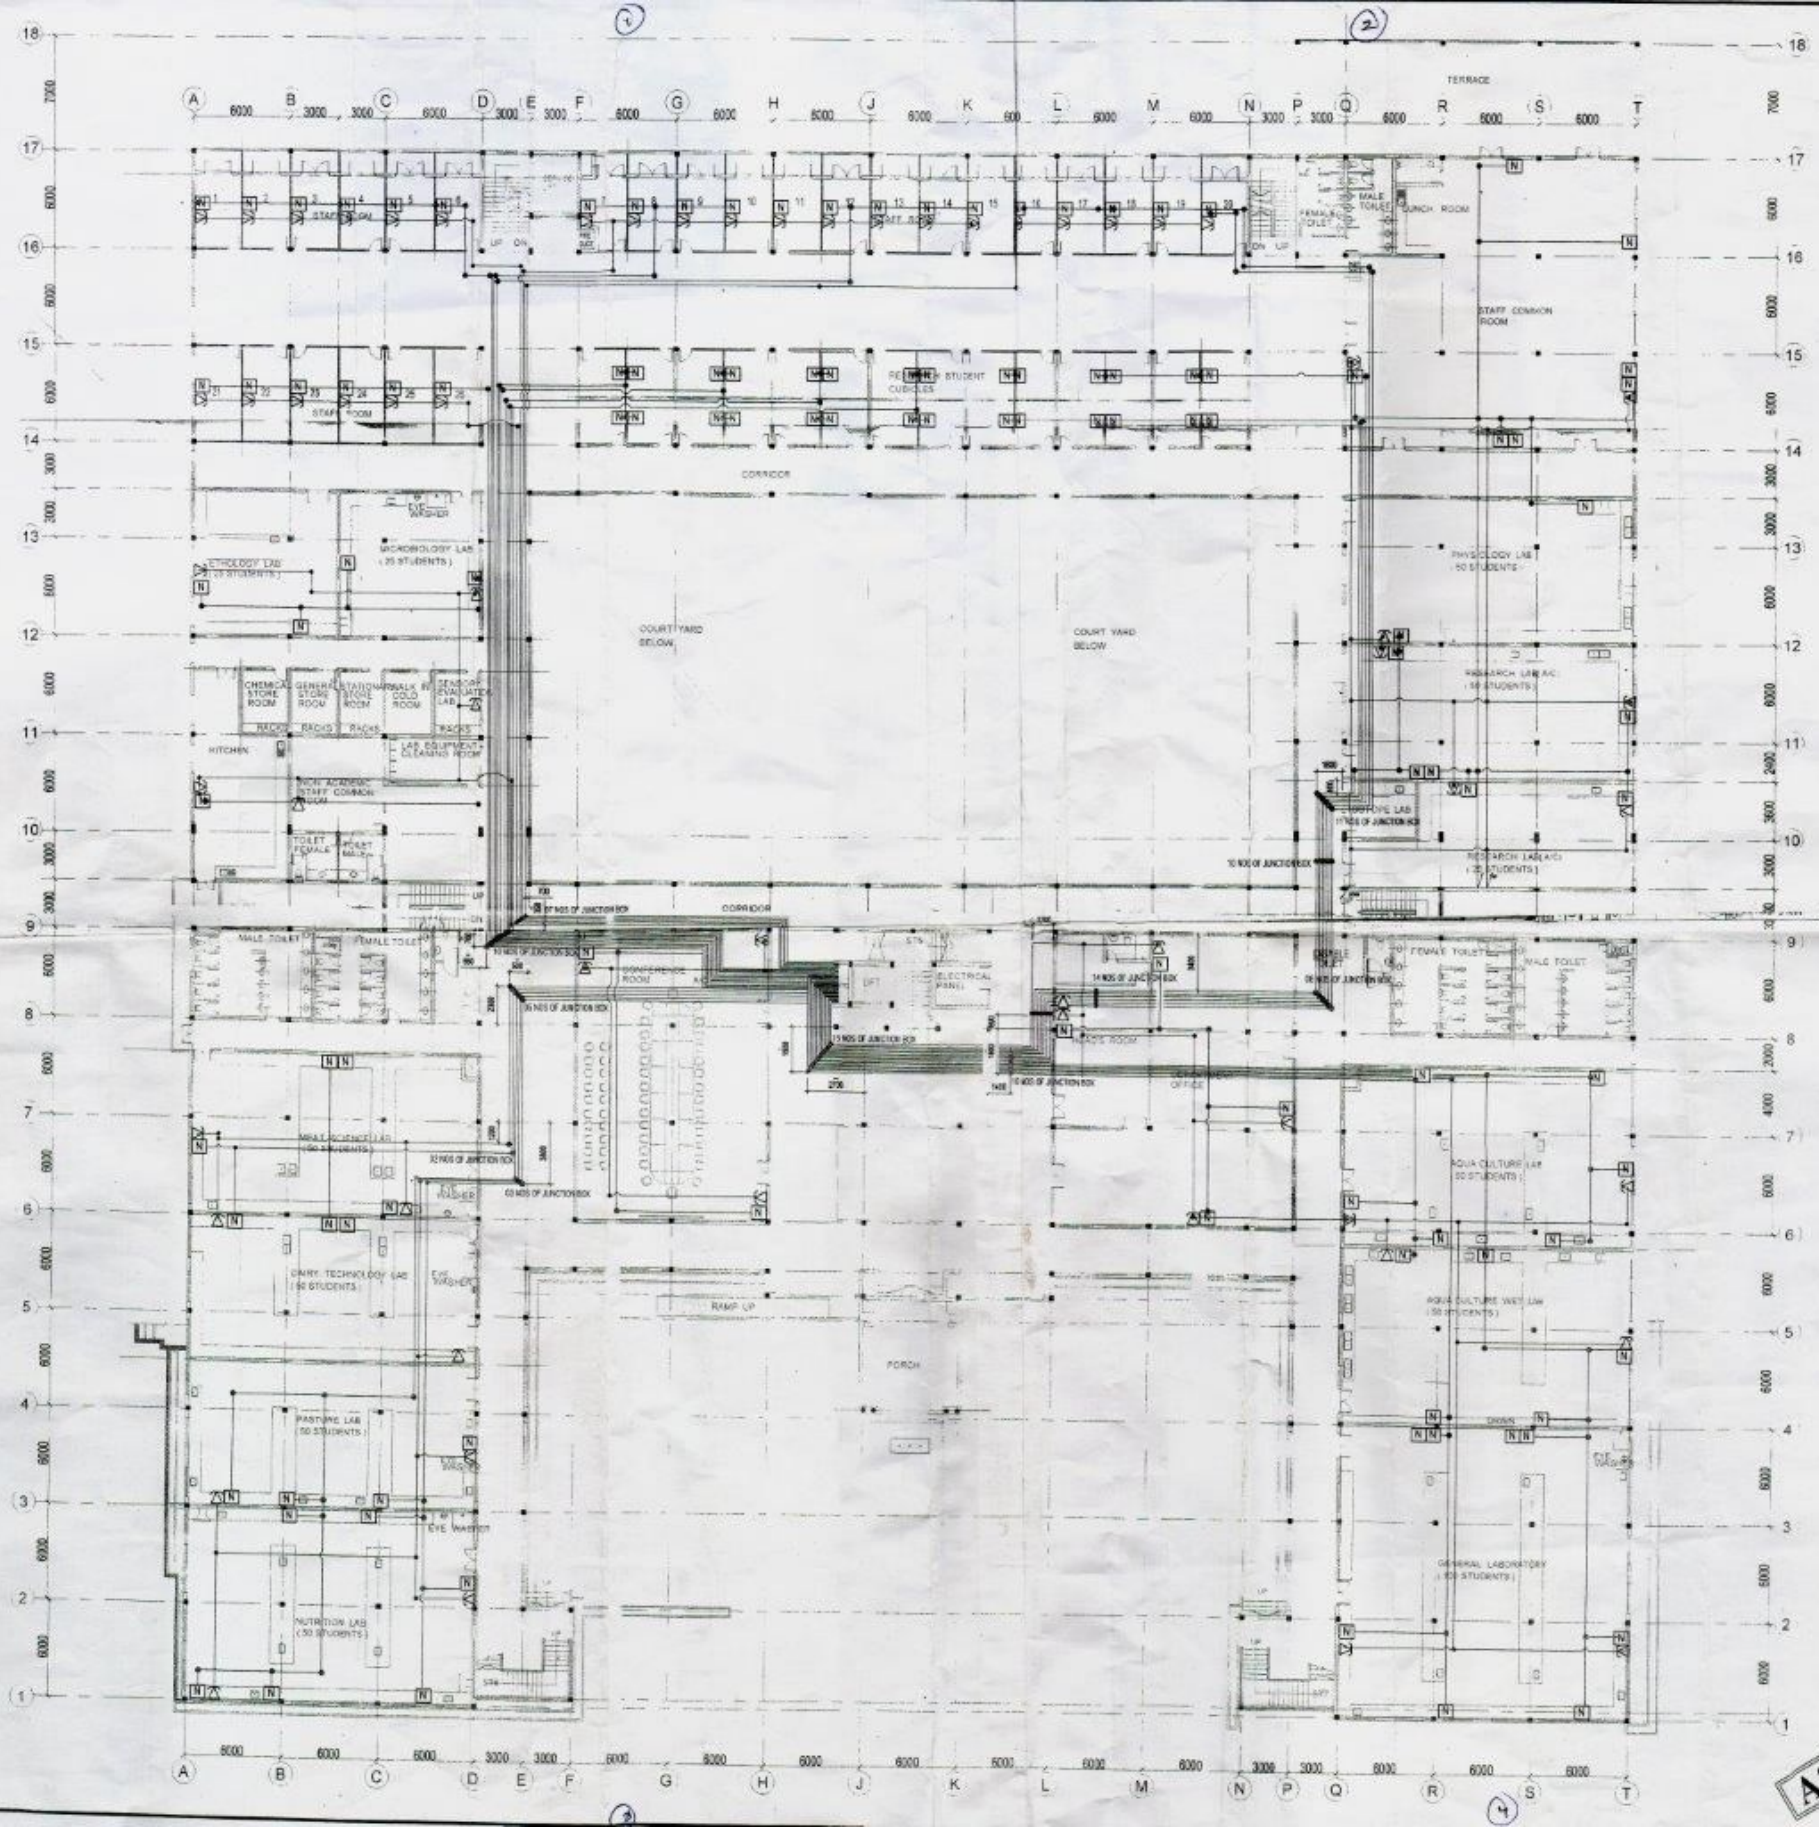
TERRACE
STAFF COMMON ROOM
CORRIDOR
COURT YARD BELOW
COURT YARD BELOW
PHYSIOLOGY LAB (50 STUDENTS)
RESEARCH LAB (A/C) (50 STUDENTS)
CHEMICAL STORE ROOM
GENERAL STORE ROOM
STATIONARY STORE ROOM
WALK IN COLD ROOM
SENSORY EVALUATION LAB
RACKS
KITCHEN
LAB EQUIPMENT CLEANING ROOM
NON ACADEMIC STAFF COMMON ROOM
MALE TOILET
FEMALE TOILET
CORRIDOR
ELECTRICAL PANEL
OFFICE
MILK SCIENCE LAB (50 STUDENTS)
DAIRY TECHNOLOGY LAB (50 STUDENTS)
RAMP UP
PORCH
AQUA CULTURE LAB (50 STUDENTS)
AQUA CULTURE WET LAB (50 STUDENTS)
DRAIN
GENERAL LABORATORY (50 STUDENTS)
PASTURE LAB (50 STUDENTS)
NUTRITION LAB (50 STUDENTS)
EYE WASHER
AS BI